
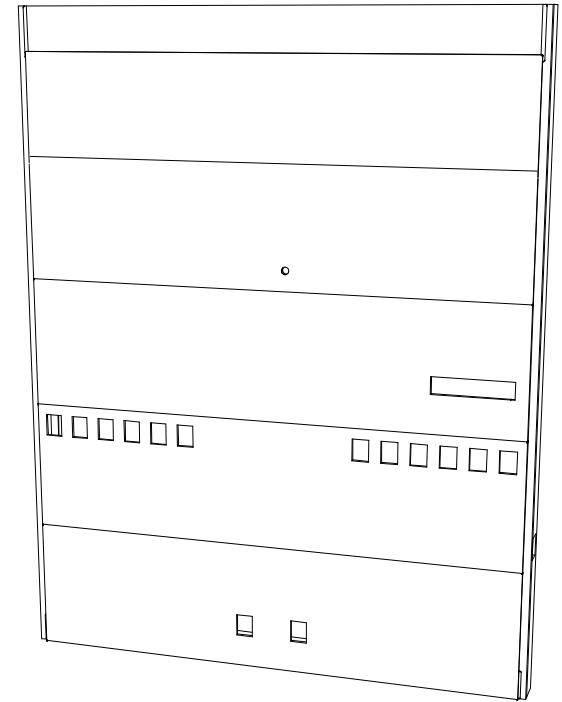
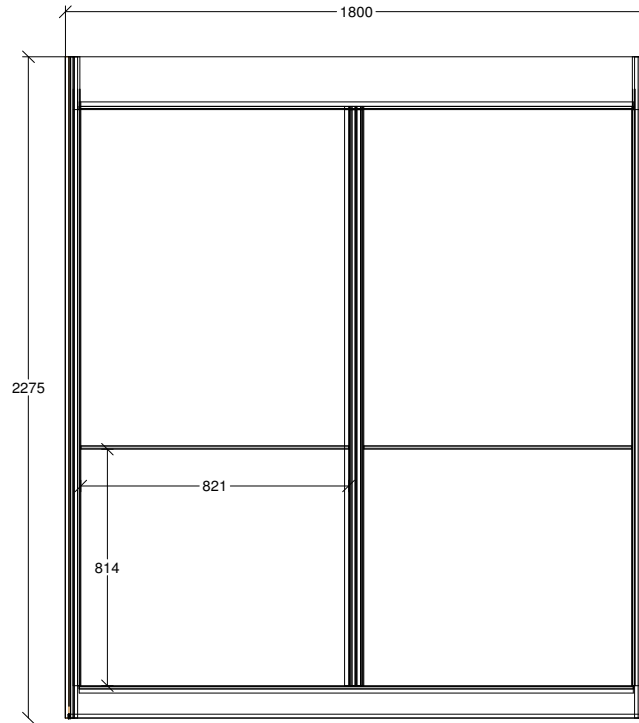


Standard Bedhead

All Penetration sizes are cutout size only

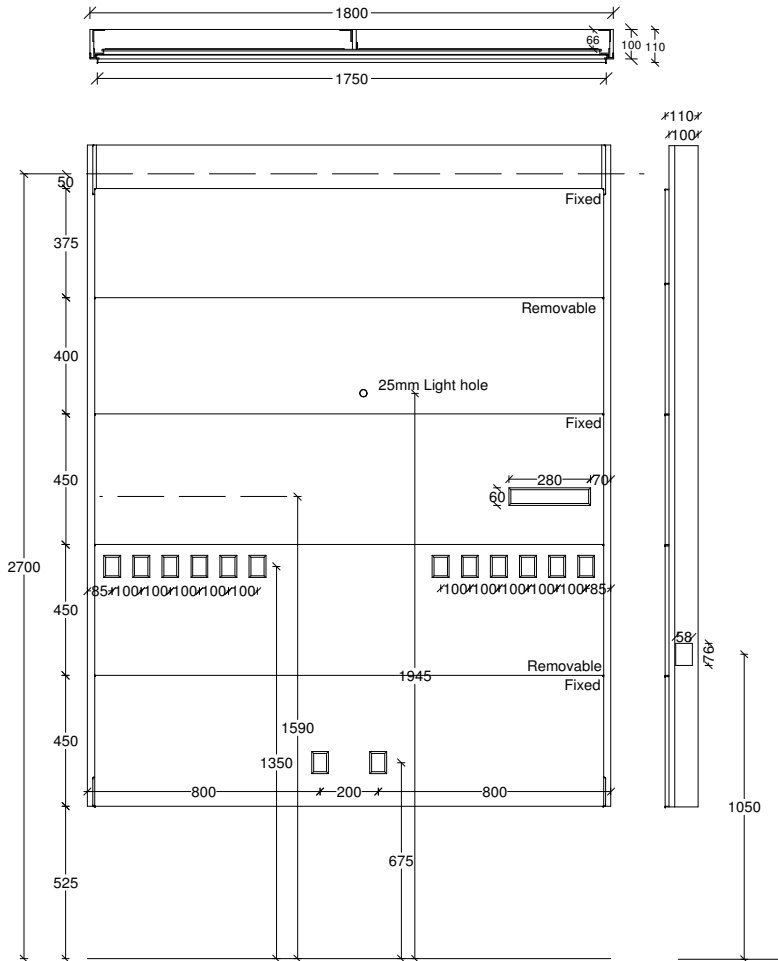

Panel finish: 13mm Gloss

Aqualoo
LEADERS IN WASHROOM SOLUTIONS
33 Morgan Street
Rockingham, 6168
Sales@WCCI.com.au

Revision	Revision Description	Date	Scale
A	Issue for review	7/05/14	1:15 @A3
1	Issue for construction	23/05/14	
2	Issue for construction	13/06/14	
3	Issue for construction	25/09/15	
4	As Built	19/03/15	
5	As Built	08/07/15	

Client _____ Project Name _____ Drawing _____ Rev _____ 5
Sheet Name _____