

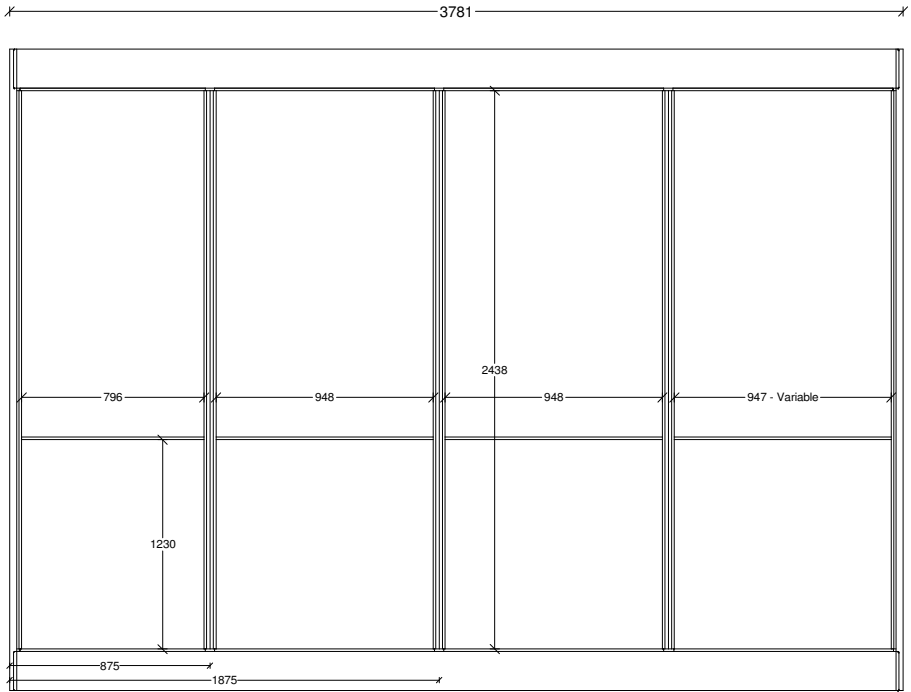
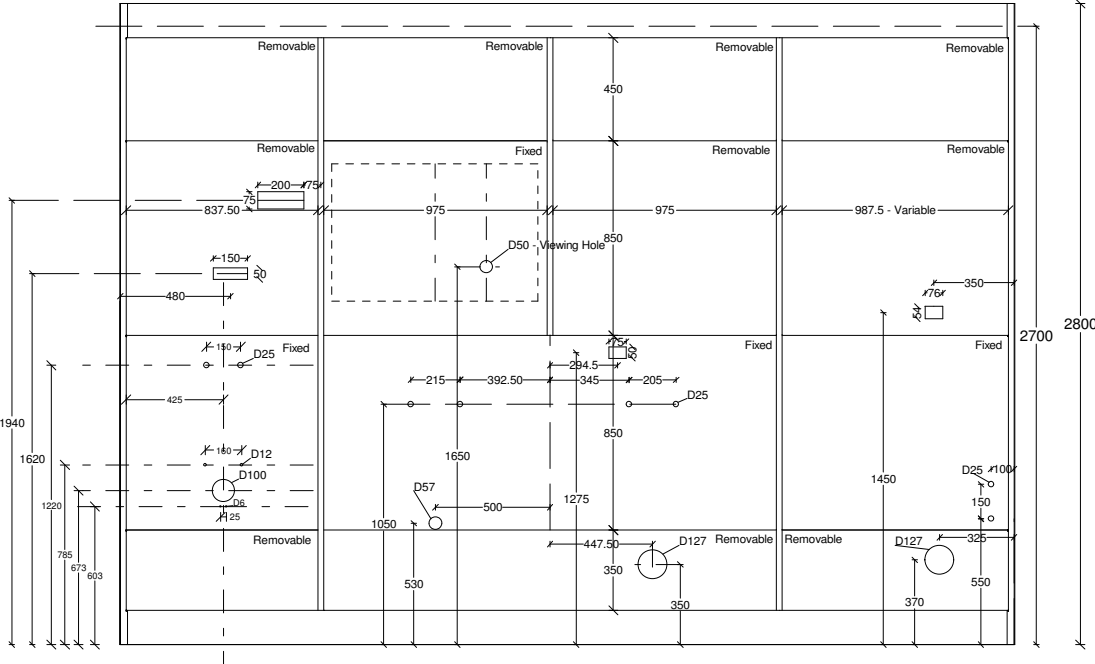
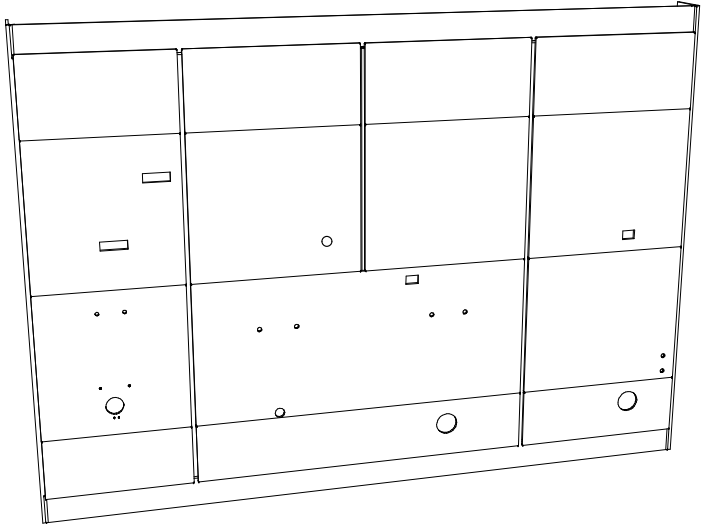


Standard Left Hand Dirty Utility

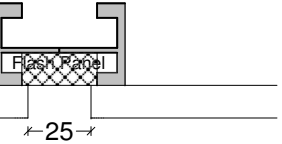

D = Hole Diameter

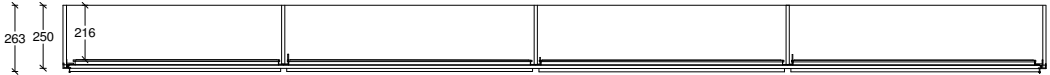

33 Morgan Street
 Rockingham, 6168
 Sales@WCCI.com.au

Revision	Revision Description	Date	Scale	Client	Project Name	Drawing	Rev
A	Issue for review	06/03/14	1:15 @A3				2
B	Changes made from last review	19/03/14					
C	Height from ceiling changed to suit	20/03/14					
D	Penetrations Updated	08/04/14					
E	Dimensions Added	16/06/14					
F	Braces included in plan view	16/06/14					
G	Ceiling Height Noted - 3D Drawing updated	21/06/14					
H	Flash gaps added to vertical splits to assist panel installation	23/06/14					
I	Penetrations updated	16/07/14					
1	As Built	30/09/14					
2	As Built	08/07/15					

Sheet Name