

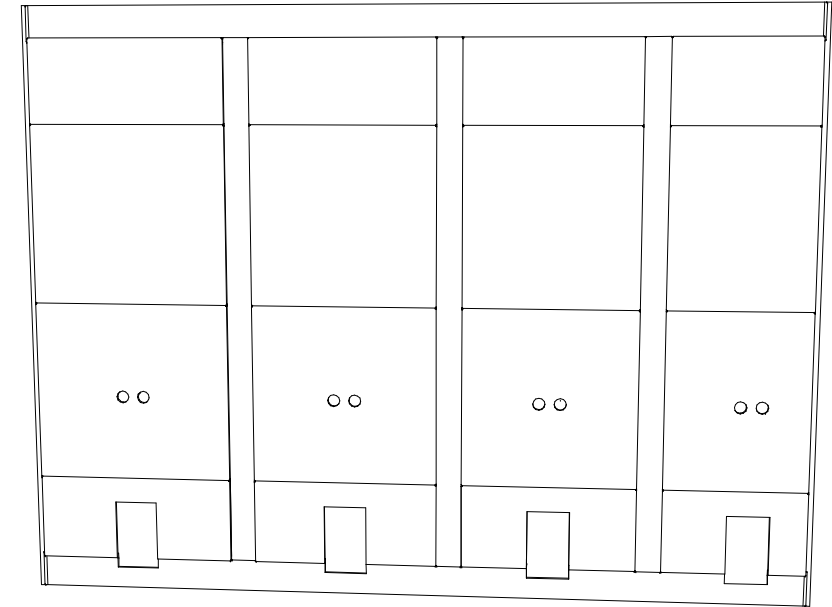
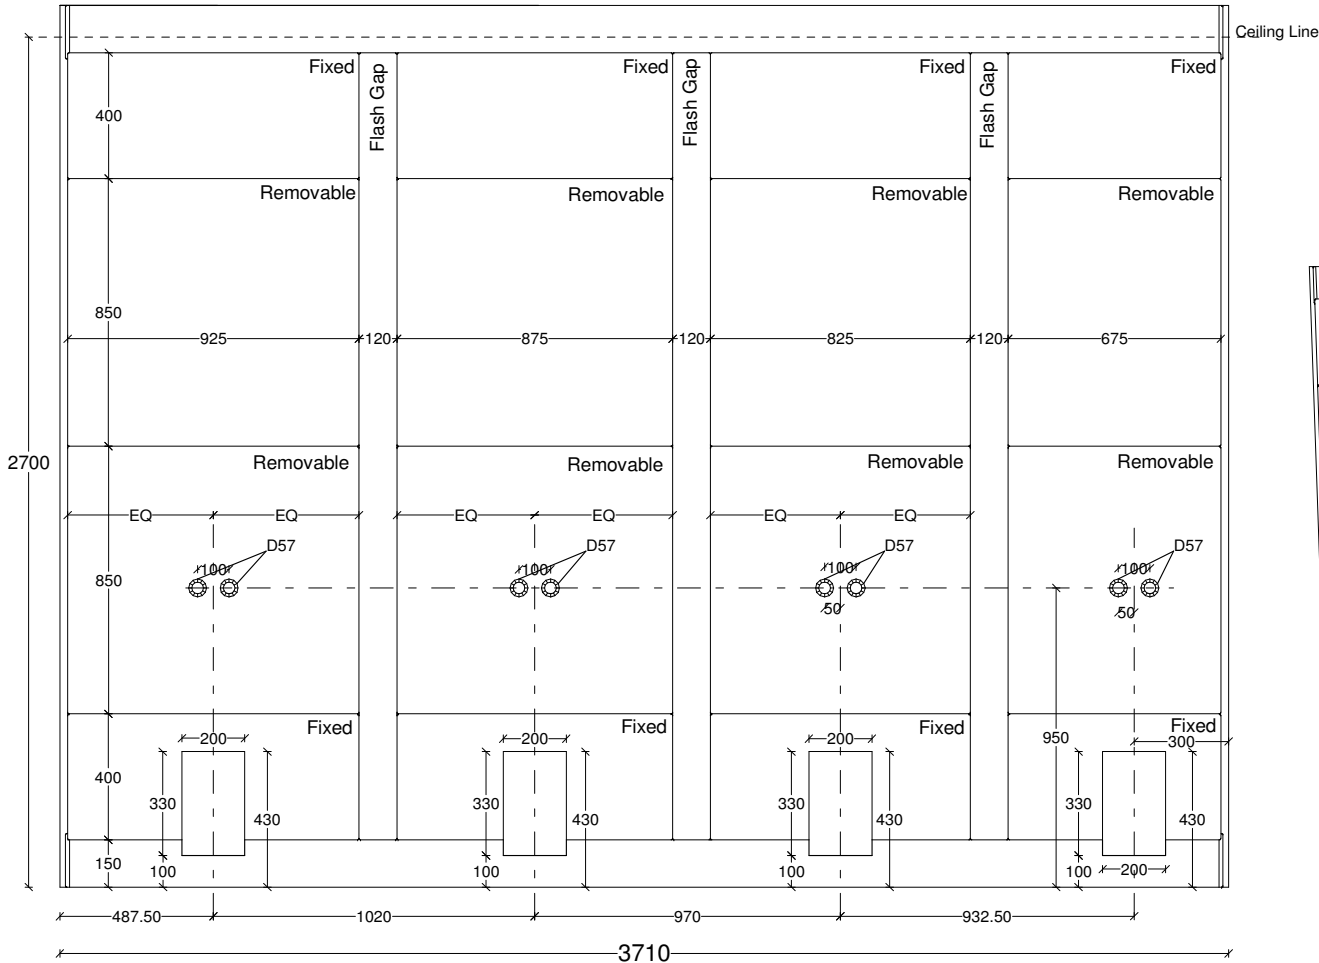


Standard WC Unit

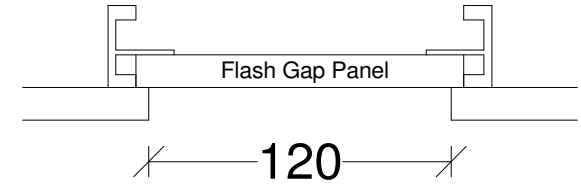

Panel Finish: 13mm Gloss White
D = Hole Diameter

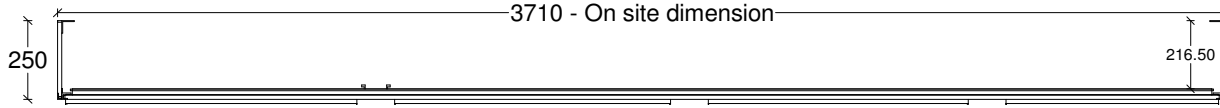

33 Morgan Street
Rockingham, 6168
Sales@WCCI.com.au

Revision	Revision Description	Date
A	Issue for review	30/05/14
B	Changes made from last review	29/10/14
1	For Construction	20/11/14
2	As Built	20/03/15
3	As Built	08/07/15

Scale
1:15 @A3

Client

Project Name

Drawing

Rev 3

Sheet Name