

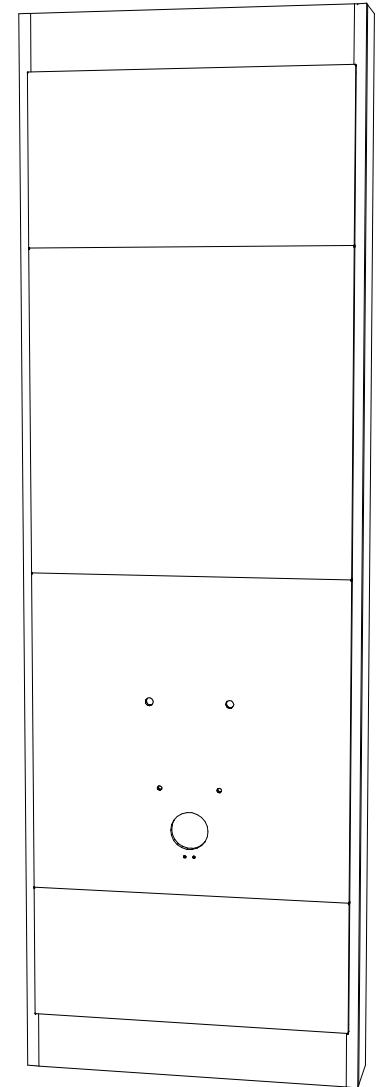
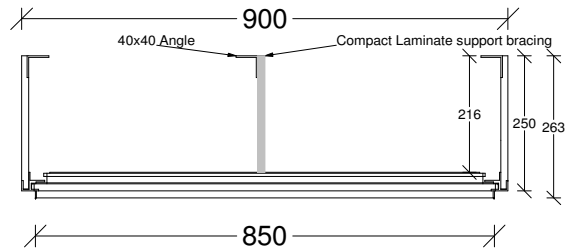


Standard Nursing Station Clinic 600 Basin

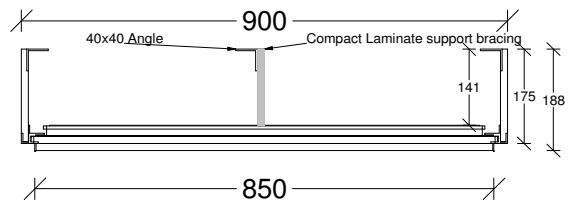

Panel Finish: Room dependant

D = Hole Diameter

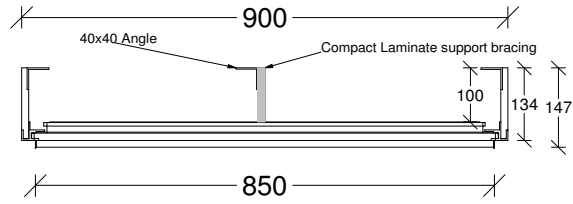

33 Morgan Street
Rockingham, 6168
Sales@WCCI.com.au

Revision	Revision Description	Date	Scale	Client	Project Name	Drawing	Rev
A	Issue for review	06/03/14	1:15 @A3				
B	Changes made from last review	18/03/14				Sheet Name	
C	Basin height noted	30/04/14					
D	Depth adjusted to suit 100mm clear internal	16/05/14					
E	Added dimensions	05/06/04					
F	Strut added	02/07/14					
G	Strut detail added, Hole diameters updated	09/07/14					
1	For Construction	12/11/14					
2	As Built	23/03/15					
3	As Built	08/07/15					